
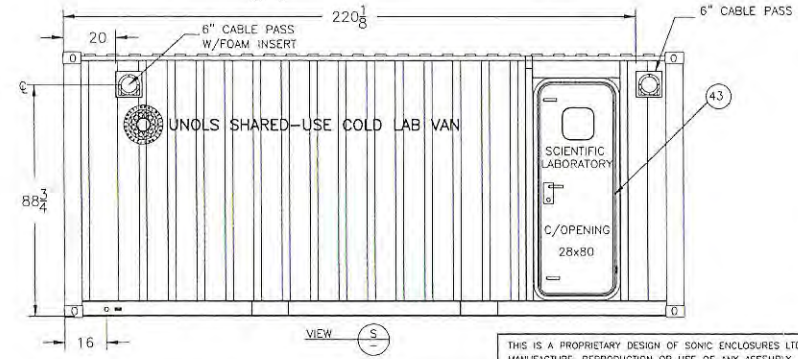
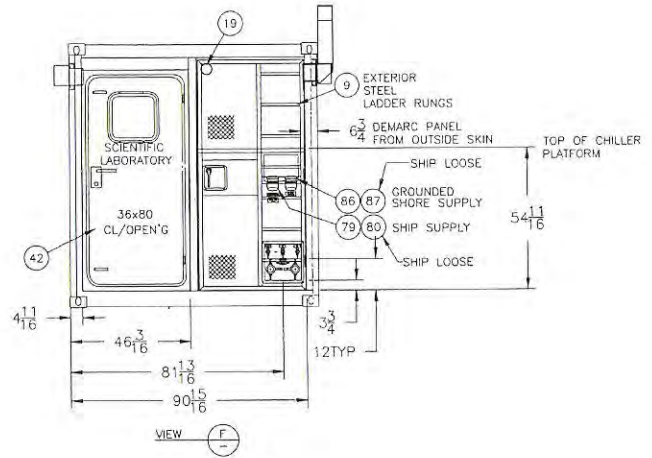
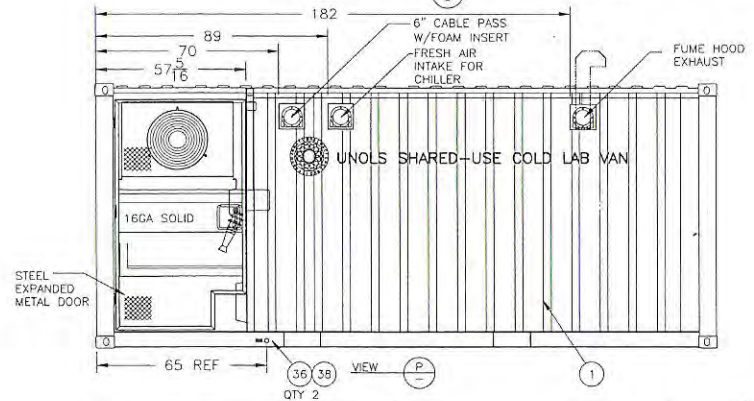
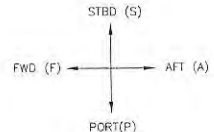
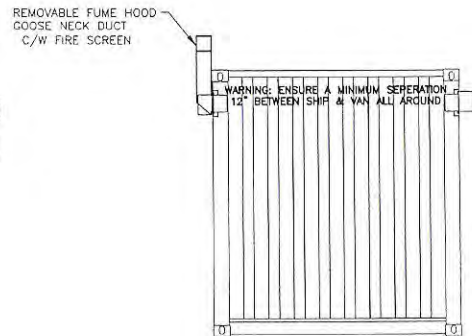



REVISIONS				
ZONE	LTR	DESCRIPTION	DATE	APPROVED
		ISSUED FOR APPROVAL		
A		CHANGED AS REQUESTED BY CUSTOMER	21.APR.03	
B		MODIFIED CHILLER DIM.	03.JULY.03	
C		AS BUILT	08.JUN.04	

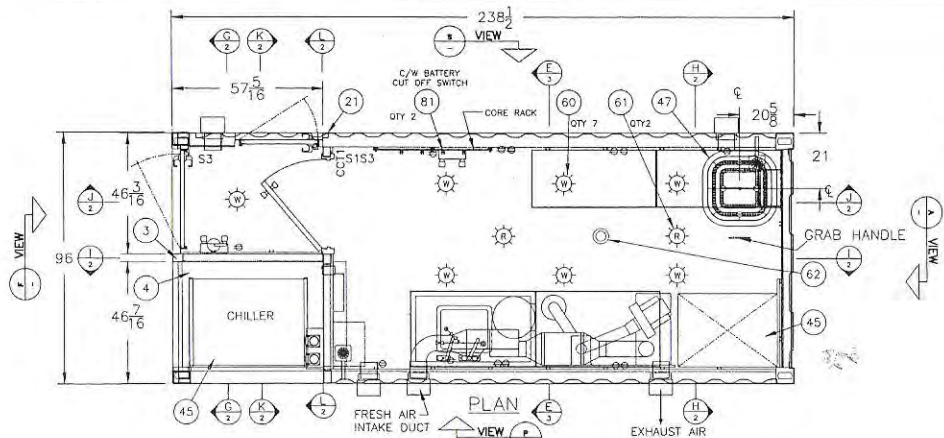


THIS IS A PROPRIETARY DESIGN OF SONIC ENCLOSURES LTD. MANUFACTURE, REPRODUCTION OR USE OF ANY ASSEMBLY, SUBASSEMBLY OR PART IS PERMISSIBLE ONLY IF EXPRESSLY PRIOR AUTHORIZED IN WRITING BY SONIC ENCLOSURES LTD.

UNLESS OTHERWISE SPECIFIED DIMENSIONS ARE IN INCHES TOLERANCES FRACTIONAL ± 1/16" DECIMAL ± .005" ANGULAR ± 15° DO NOT SCALE DRAWING	CONTRACT No. 625.2.01	DATE 26.MAR.03			7127 HONEYMAN STREET DELTA B.C. V4G 1E3 PH - 604 946-6100 FX - 604 946-6967
	DRAWN K MINHAS	CHECK DAVE D	DESIGN DAVE D	GENERAL ARRANGEMENT COLD STEEL VAN	
	CUSTOMER UNOLS : NSF	SCALE NTS	FSCM NO	DWG No 625201-4-02	REV. C
		RELEASE DATE 22APR03	SHEET 1 OF 4		


REVISIONS				
ZONE	LTR	DESCRIPTION	DATE	APPROVED
		ISSUED FOR APPROVAL		
A		CHANGED AS REQUESTED BY CUSTOMER	21 APR 03	
B		REMOVED CEILING UNISTRUT	29 MAY 03	
C		MODIFIED CHILLER DIM.	04 JULY 03	
D		AS BUILT	08 JUN 04	

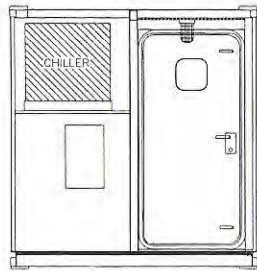


SECTION G

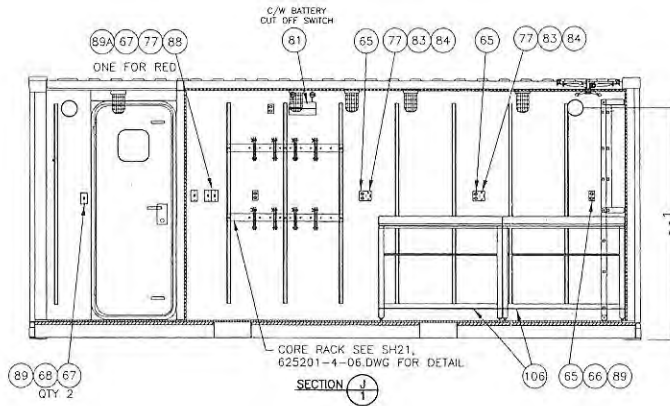


SECTION J

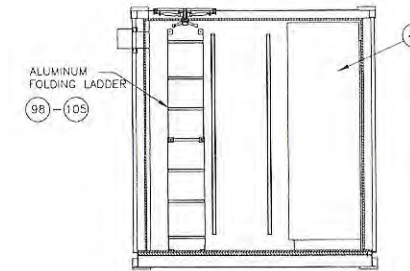


SECTION H

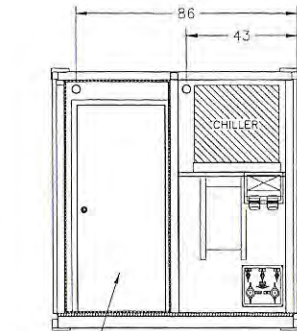

SECTION K

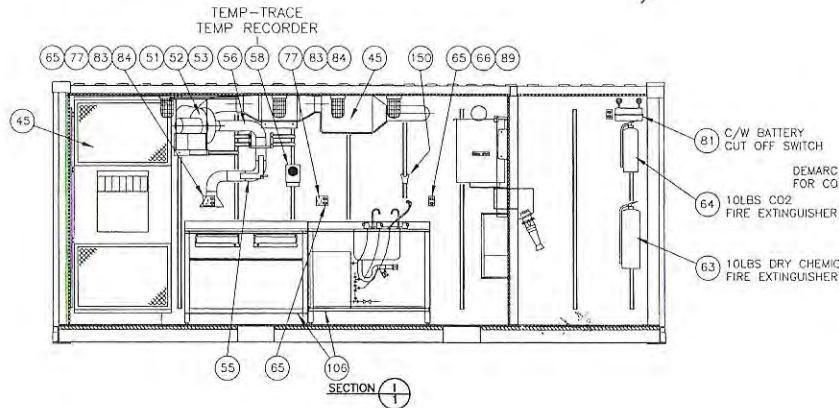

SECTION I

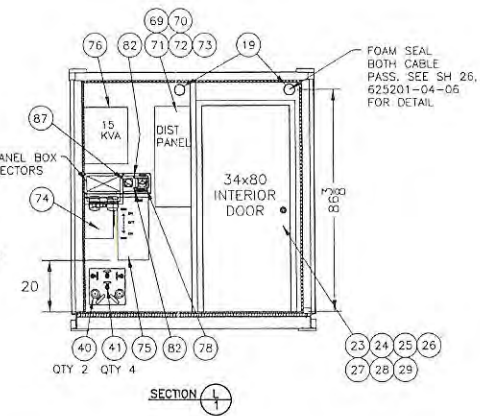


SECTION L

NOTES:-

1. ALL ELECTRICAL WIRING TO BE SURFACE MOUNTED USING 3/4" EMT, EXCEPT VERTICAL RUNS TO RECEPTACLES, WHICH ARE TO BE 1" EMT.
2. MINIMUM WIRE SIZE IS TO BE #12AWG
3. ALL CABLE/WIRE TO BE STRANDED, T-90
4. CONDUIT IS TO BE RUN ON THE WALL SURFACE AND NOT ON THE UNISTRUT.

THIS IS A PROPRIETARY DESIGN OF SONIC ENCLOSURES LTD. MANUFACTURE, REPRODUCTION OR USE OF ANY ASSEMBLY, SUBASSEMBLY OR PART IS PERMISSIBLE ONLY IF EXPRESSLY PRIOR AUTHORIZED IN WRITING BY SONIC ENCLOSURES LTD.

UNLESS OTHERWISE SPECIFIED DIMENSIONS ARE IN INCHES TOLERANCES FRACTIONAL ± 1/16" DECIMAL ± .031" ANGULAR ± 15" SEE NOTE SCALE DRAWING	CONTRACT No. 625.2.01	DATE 15 JAN 03	 7127 HONEYMAN ST. DELTA B.C. V4G 1E2 PH- 604 946-6100 FX- 604 946-6967
	DRAWN K MINHAS CHECK DAVE D DESIGN DAVE D DESIGN ACTIVITY CUSTOMER UNOLS: NSF	DATE 15 JAN 03 02 MAY 03 15 JAN 03	
	SIZE FSCM NO	DWG No 625201-4-02	REV. D
	SCALE NTS	RELEASE DATE 21 APR 03	SHEET 2 OF 4