
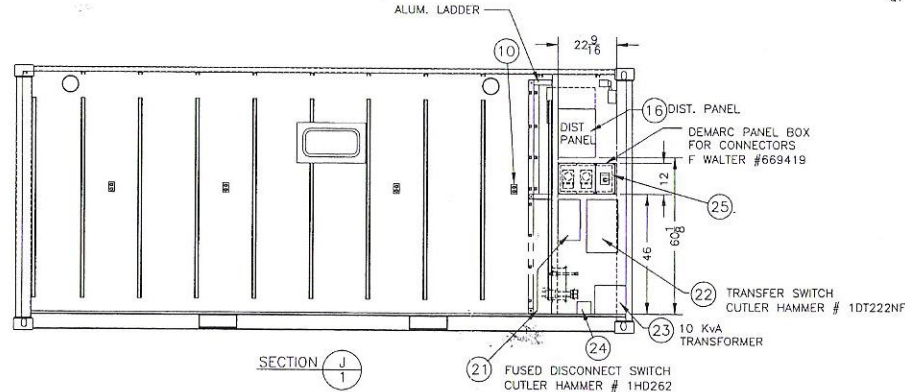
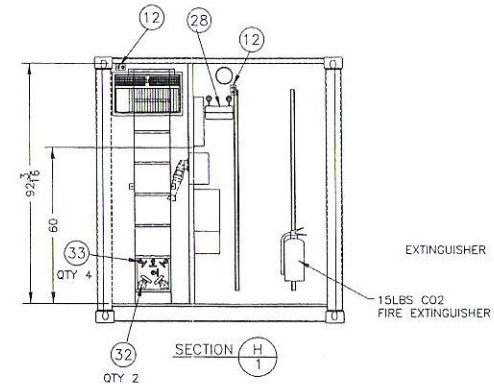
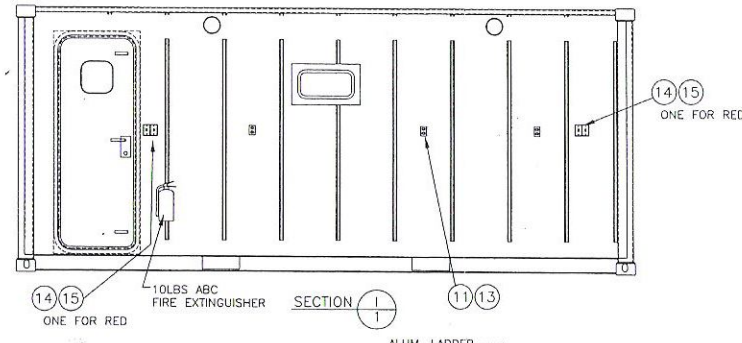



ZONE LTR		REVISIONS	DATE	APPROVED
		DESCRIPTION		
B		ISSUED FOR APPROVAL		
B		MOVE WIRE PASS CLOSER TO OVERHEAD	JULY4,01	
C		AS BUILT	SEPT11,01	



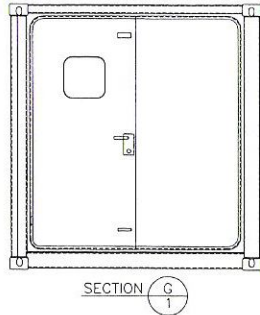


- NOTES:-
1. ALL ELECTRICAL WIRING TO BE SURFACE MOUNTED USING EMT
 2. MINIMUM WIRE SIZE IS TO BE #12AWG
 3. ALL CABLE/WIRE TO BE STRANDED, XLPE-90
 4. CONDUIT IS TO BE RUN ON THE WALL SURFACE AND NOT ON THE UNISTRUT.

THIS IS A PROPRIETARY DESIGN OF SONIC BARRIER SOUND PRODUCTS LTD. MANUFACTURE, REPRODUCTION OR USE OF ANY ASSEMBLY, SUBASSEMBLY OR PART IS NOT PERMISSIBLE EXCEPT IF EXPRESSLY PRIOR AUTHORIZED IN WRITING BY SONIC BARRIER SOUND PRODUCTS LTD.

UNLESS OTHERWISE SPECIFIED DIMENSIONS ARE IN INCHES. TOLERANCES FRACTIONAL ± 0.01" DECIMAL ± 0.01" ANGULAR ± 15° DO NOT SCALE DRAWING	CONTRACT No. 625.1.01	DATE 01/06/27	 7973 PROGRESS WAY DELTA B.C. V4G 1A3 PH- 604 946-6100 FX- 604 946-6967			
	DRAWN K MINHAS	CHECK			TITLE INTERIOR VIEWS STANDARD ALUMINUM VAN	
DESIGN	DESIGN ACTIVITY	CUSTOMER UNOLS	SIZE	FSCM NO	DWG No 625101-02	REV. C
SCALE NTS		RELEASE DATE 01/09/11	SHEET 2 OF 5			

REVISIONS				
ZONE	LTR	DESCRIPTION	DATE	APPROVED
		ISSUED FOR APPROVAL		
B		MOVE FUME HOOD TO RIGHT & LADDER	01/07/04	
		SHOWN IN FOLDED POSITION		
C		AS BUILT	01/09/11	

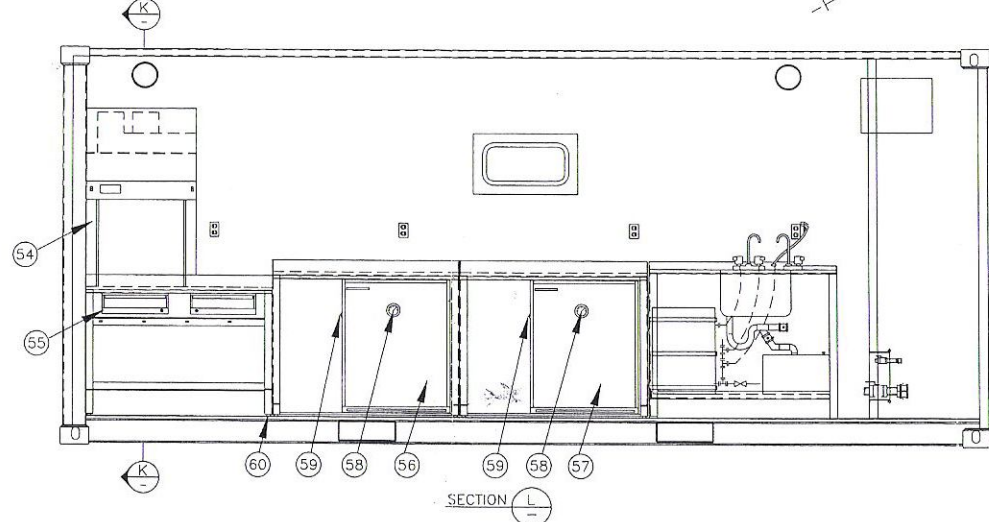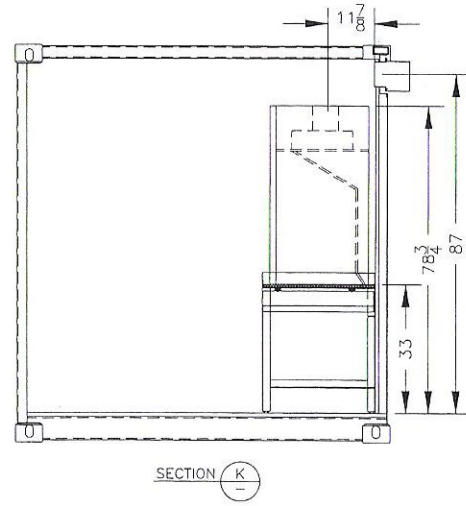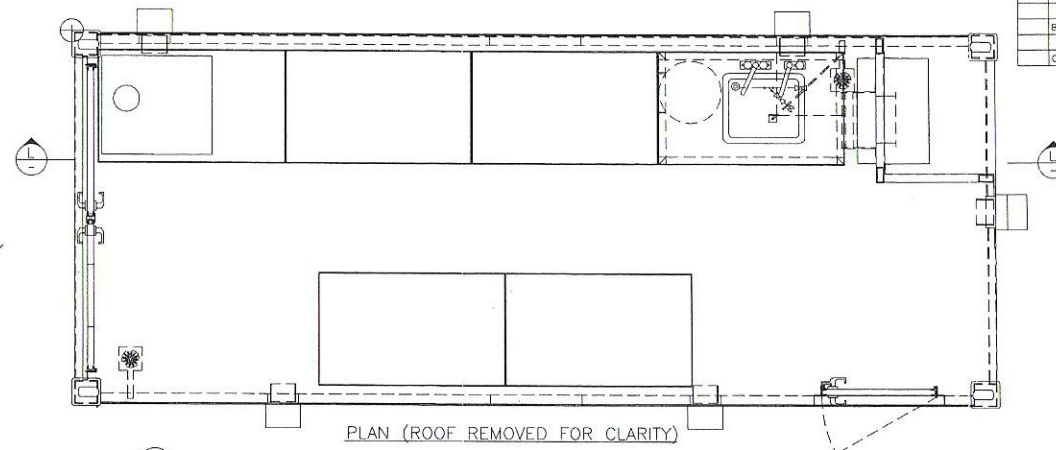

THIS IS A PROPRIETARY DESIGN OF SONIC BARRIER SOUND PRODUCTS LTD. MANUFACTURE, REPRODUCTION OR USE OF ANY ASSEMBLY, SUBASSEMBLY OR PART IS NOT PERMISSIBLE EXCEPT IF EXPRESSLY PRIOR AUTHORIZED IN WRITING BY SONIC BARRIER SOUND PRODUCTS LTD.

UNLESS OTHERWISE SPECIFIED DIMENSIONS ARE IN INCHES
TOLERANCES
FRACTIONAL ± 1/16"
DECIMAL ± .001"
ANGULAR ± 15°
DO NOT SCALE DRAWING

VAN TYPE
ISOTOPE
TRACE METAL

CONTRACT No.
625.1.01
DRAWN
K MINHAS
CHECK
DESIGN
DESIGN ACTIVITY
CUSTOMER
UNOLS
DATE
01/06/29

		7973 PROGRESS WAY DELTA B.C. V4G 1A3 PH- 604 946-6100 FX- 604 946-6957	
		TITLE MODULE LAYOUT	
SIZE	FSCM NO	DWG No	REV.
		625101-02	C
SCALE NTS	RELEASE DATE	01/06/27	SHEET 5 OF 5